

Reviewed  
2/20/07  
28

STATE OF UTAH  
DEPARTMENT OF NATURAL RESOURCES  
DIVISION OF OIL, GAS AND MINING  
1594 West North Temple - Suite 1210  
Box 145801  
Salt Lake City, Utah 84114-5801  
Telephone: (801) 538-5291  
Fax: (801) 359-3940

LARGE MINING OPERATIONS 2006 PROGRESS REPORT  
January 1, 2006 to December 31, 2006

The information required in this form are based on provisions of the Mined Land Reclamation Act, Title 40-8, and the rules as under the Utah Minerals Regulatory Program.

1. Mine Permit Number: M/035/026  
2. Mine Name: Point of the Mountain  
3. Name of Operator/Permittee: Geneva Rock Products, Inc.

Note: If Operator's address, company representative or phone number have changed, please provide a replacement page to the Notice of Intention.

4. Mine Location: 15547 South 300 West, Draper

5. Report the gross amount of ore mined and waste moved, as well as the arrangement, positioning, or distribution of the material:

Gross Ore Mined 6,385,826 Tons, or \_\_\_\_\_ yd<sup>3</sup>

Waste Material Moved 0 Tons, or \_\_\_\_\_ yd<sup>3</sup>

New Disturbance 0 Acres during 2006

Area Reclaimed 0 Acres during 2006

Total Disturbed Area 188.4 Acres\*

Was the ore shipped off site? If not, where is the ore located? yes

Where is the waste located? \_\_\_\_\_

\*Total life of mine disturbance to the end of 2006.

6. Briefly describe the reclamation work performed during the past year. A map showing reclaimed areas and dates is suggested. (Submit form MR-SITE for an application for full or partial bond/site release).

none

7. Include an updated map depicting surface disturbance and reclamation performed during the year, prepared in accordance with Rule R647-4-105.

I hereby certify, under penalties of law, the information provided in this report is true and correct to the best of my knowledge and belief.

Name (Typed or Print): Tony Christofferson

Title of Operator: Geneva Rock - Property/Environmental manager

Signature of Operator: Tony Christofferson

Date: 1-30-07

RECEIVED


JAN 30 2007

DIV. OF OIL, GAS & MINING



# Geneva Rock Point of the Mtn. Pit

N →  
Scale 1" = 500'

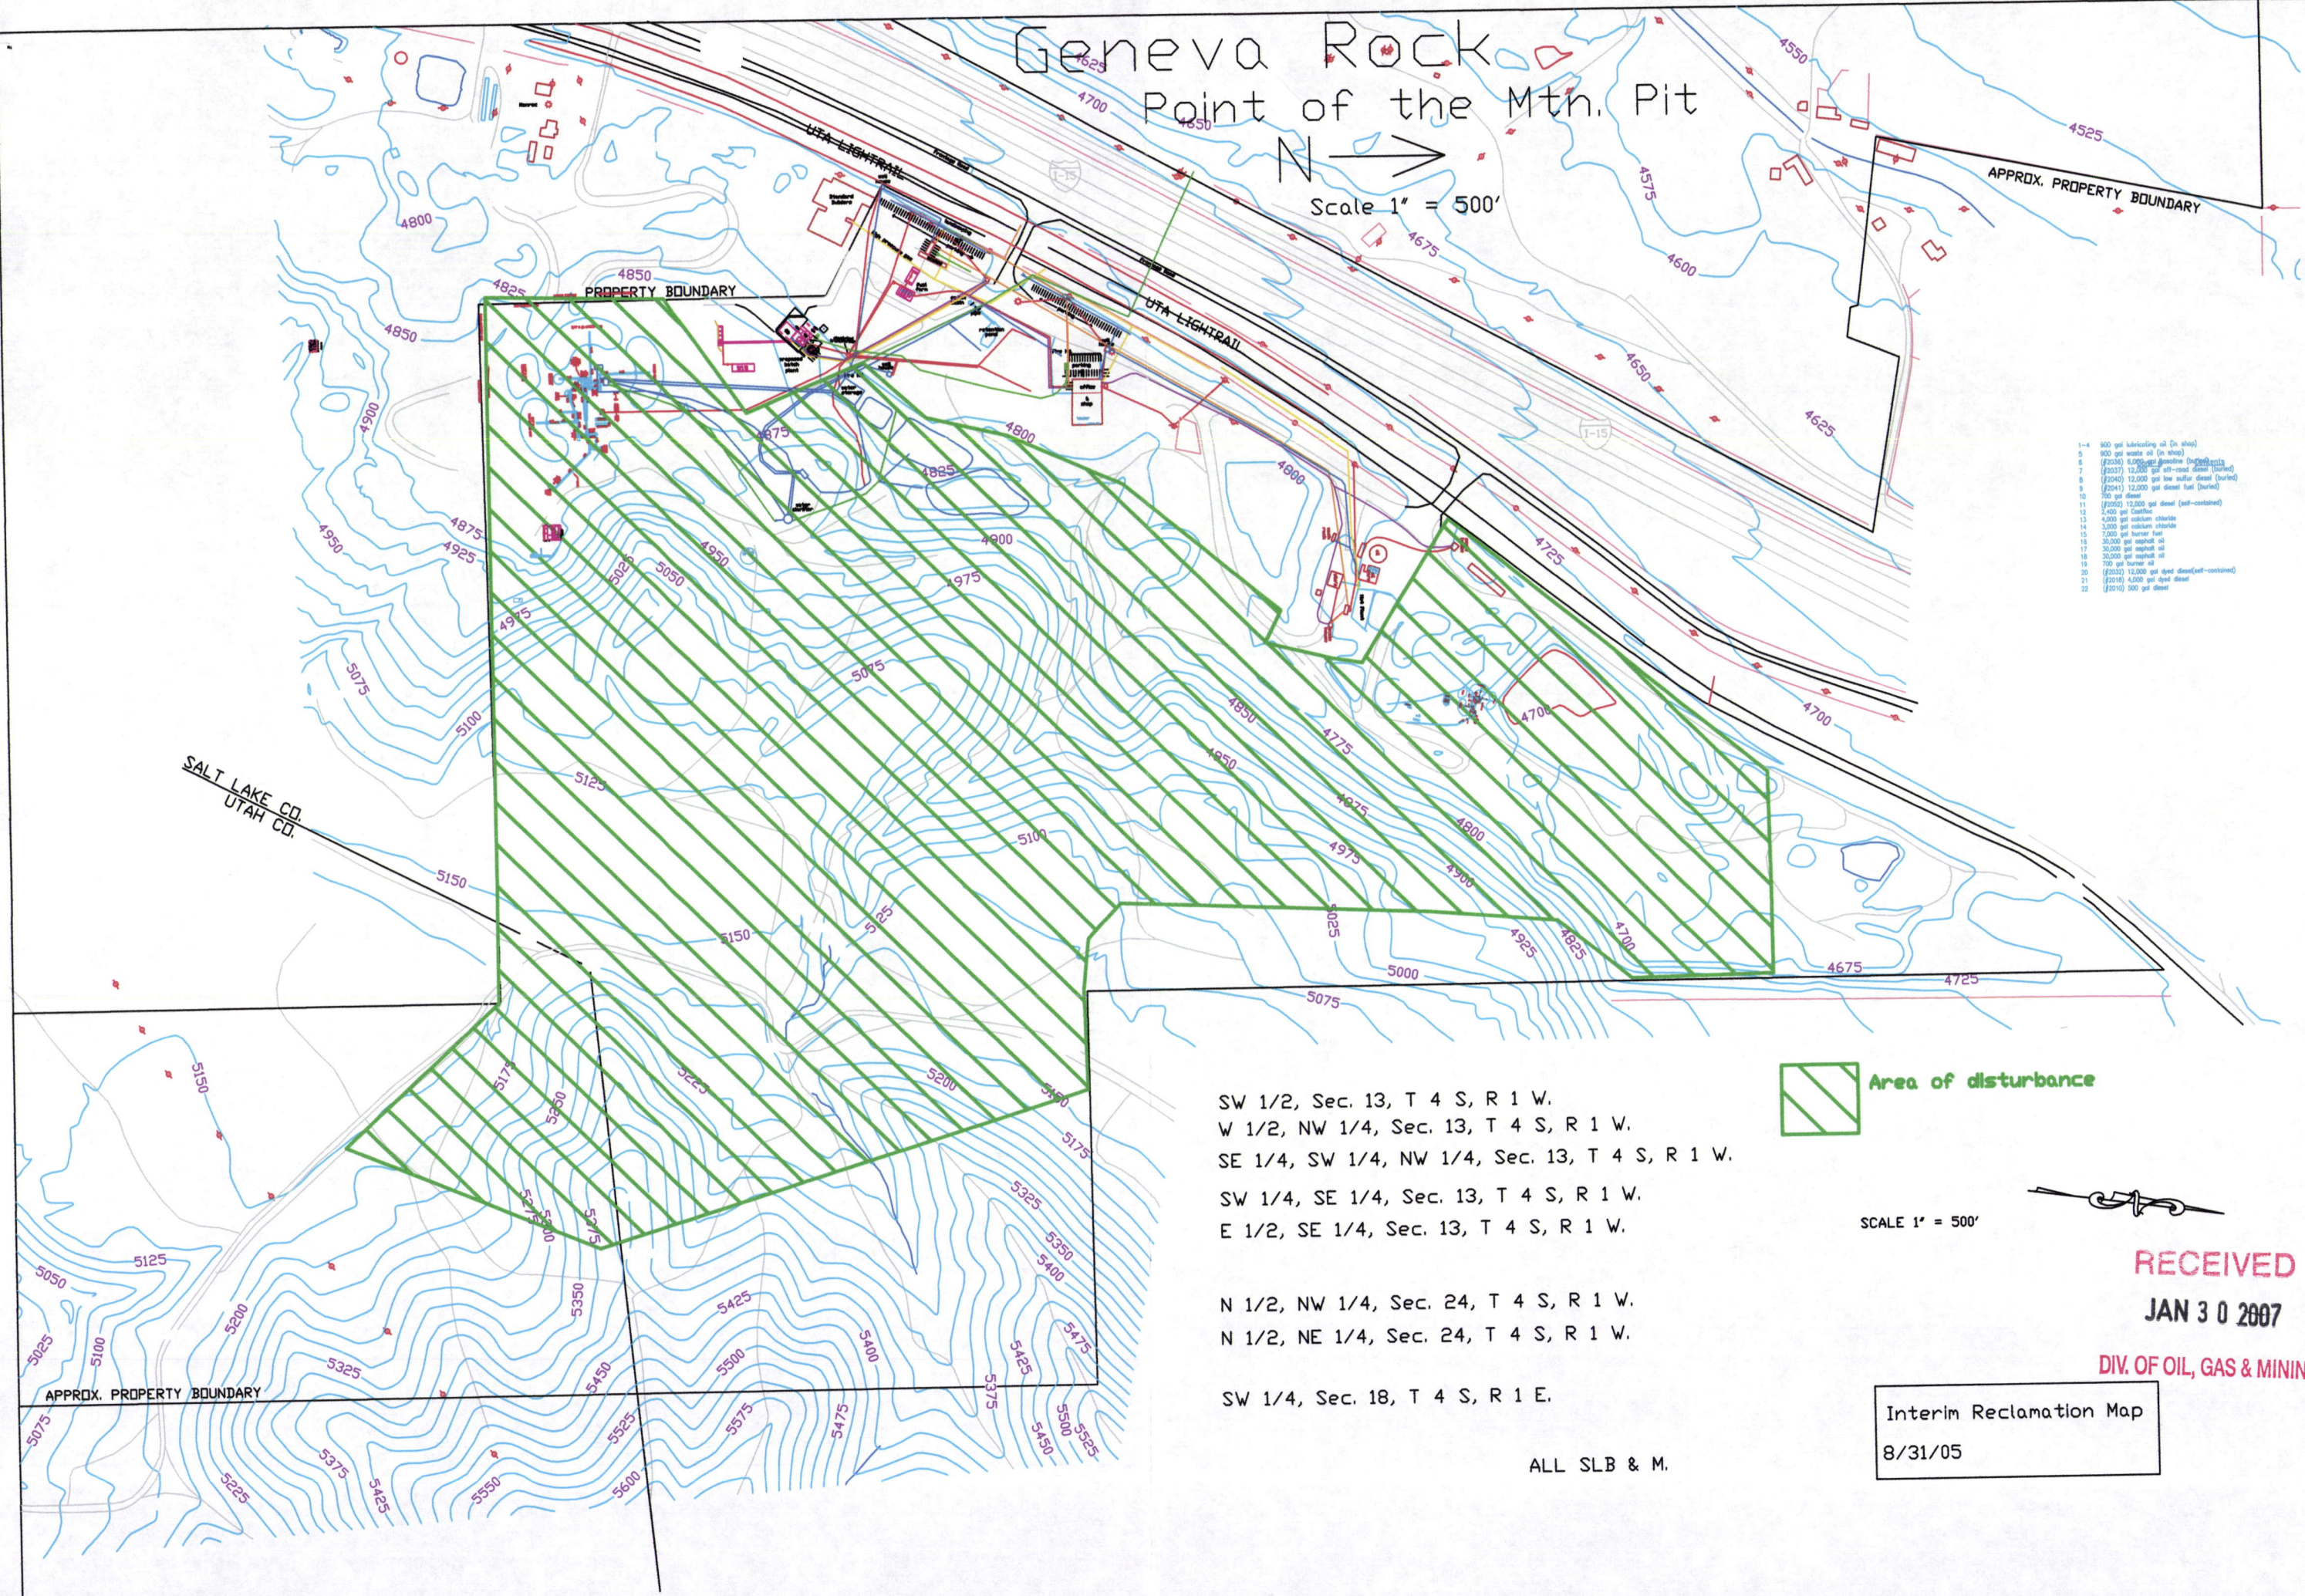

- 1-4 900 gal lubricating oil (in shop)
- 5 900 gal waste oil (in shop)
- 6 (2008) 6,000 gal gasoline (in shop)
- 7 (2007) 12,000 gal oil-road diesel (buried)
- 8 (2004) 12,000 gal low sulfur diesel (buried)
- 9 (2004) 12,000 gal diesel fuel (buried)
- 10 750 gal diesel
- 11 (2005) 12,000 gal diesel (well-contained)
- 12 2,400 gal Couflow
- 13 4,000 gal sodium chloride
- 14 2,000 gal sodium chloride
- 15 7,000 gal burner fuel
- 16 35,000 gal asphalt oil
- 17 30,000 gal asphalt oil
- 18 30,000 gal asphalt oil
- 19 700 gal burner oil
- 20 (2005) 12,000 gal diesel (well-contained)
- 21 (2010) 4,000 gal diesel
- 22 (2010) 500 gal diesel

SW 1/2, Sec. 13, T 4 S, R 1 W.  
W 1/2, NW 1/4, Sec. 13, T 4 S, R 1 W.  
SE 1/4, SW 1/4, NW 1/4, Sec. 13, T 4 S, R 1 W.  
SW 1/4, SE 1/4, Sec. 13, T 4 S, R 1 W.  
E 1/2, SE 1/4, Sec. 13, T 4 S, R 1 W.  
  
N 1/2, NW 1/4, Sec. 24, T 4 S, R 1 W.  
N 1/2, NE 1/4, Sec. 24, T 4 S, R 1 W.  
  
SW 1/4, Sec. 18, T 4 S, R 1 E.

 Area of disturbance

SCALE 1" = 500'



RECEIVED  
JAN 30 2007

DIV. OF OIL, GAS & MINING

Interim Reclamation Map  
8/31/05

ALL SLB & M.